



GENERAL NOTES

1. THE HULL FROM THE KEEL TO THE 01 LEVEL IS OF STEEL CONSTRUCTION.
THE DECKHOUSE FROM THE 01 LEVEL AND UP IS OF ALUMINUM CONSTRUCTION.

CHARACTERISTICS

LENGTH OVERALL	=	63.57	m
LENGTH BETWEEN PERPENDICULARS	=	58.00	m
LENGTH ON DWL	=	61.00	m
BEAM, EXTREME	=	15.00	m
BEAM, ON DWL AT STA OF MAX AREA	=	15.00	m
BEAM, ON DWL AT MIDSHIPS	=	15.00	m
DRAFT, TO DWL, AMIDSHIPS	=	5.35	m
DRAFT, MLD BASELINE TO DWL	=	5.90	m
SLOPE OF KEEL DRAG	=	1: 37.12	
BASELINE LOCATED .55 m BELOW MLD KEEL AT MIDSHIPS			
COMPLEMENT 39 (TOTAL)			

REVISIONS

REV	ZONE	DESCRIPTION	DATE	APPROVED
1		1. SHTS 2 & 3, PORT & STBD PROFILES: REVISED GALLOWS LAYOUT TO SUIT NEW DESIGN. REVISED LOCATION OF NET SONDE WINCH FROM GALLOWS TOP TO 02 LEVEL. DELETED PLATFORM FROM INMARSAT MASTS. DELETED HANDRAILS FROM ANTENNA PLATFORMS. 2. SHTS 2 & 3, PORT & STBD PROFILES: INCORPORATED SHIP'S NAME AND NUMBER & RUDDER DRAFT MARKS. 3. SHT 2 & 3, PORT & STBD PROFILES: REVISED HANDRAILS & STANCHION LAYOUT ALONG 01 & 02 LEVEL. 4. SHT 3, PORT PROFILE: INCORPORATED GOOSENECK AT FRAME 82 & REVISED HANDRAILS TO SUIT. ITEM 1 PER ECP 0083. ITEMS 2-4 PER ENG. DEVELOPMENT.	1/3/05 RMW	1/26/05 RG
2		1. EXTENDED HULL APPLICABILITY TO INCLUDE HULL 1956. ITEM 1 PER ENGINEERING DEVELOPMENT.	3/18/05 RMW	3/21/05 FH
3		1. SH 2, OUTBOARD PROFILE: RELOCATED FORWARD LEG OF SIDE A-FRAME TO FRAME 41 1/2, MOVED SIDE SAMPLING CONTROL BOOTH AFT TO SUIT; AND MODIFIED HANDRAILS IWO BOOTH AND BASE TO SUIT. ITEM 1 PER ECP 0090.	8/8/05 AGE	10/21/05 FH
4		1. SH 1 THRU 3, EXTENDED HULL APPLICABILITY TO INCLUDE HULL 1957. 2. SH 2 & 3, CHANGED LOCATION OF LIFERAFT TO MATCH AS-BUILT CONDITIONS. 3. SH 2 & 3, CHANGED LAYOUT OF INMARSAT B AND VSAT TO MATCH AS-BUILT CONDITIONS. 4. SH 1, ADDED "AS-BUILT". ITEM 1 & 4 PER ENGINEERING DEVELOPMENT.	7/13/06 MDP	

DOCUMENT DISTRIBUTION RECORD

[illegible]

OUTBOARD PROFILE

JOB NO. M282	ITEM 085	DELIVERABLE FA01	SHEET 001	REV 04
FILE R:\M282\FUNCTIONAL DESIGN\IN WORK\HULLDWG			SHEET 1	OF 3

HULL APPLICABILITY

M282 HULL 1953										RE
M283 HULL 1956										SH
M284 HULL 1957										SH
REVISION STATUS										
DR. NUMBERS										

This drawing,
design concept and specifications
are the property of
VT Halter Marine, Inc.
and
are furnished on a confidential basis
with an expressed understanding that
they will not be copied in any manner,
used for manufacture, sold, transferred
nor used to the detriment of said firm
without written permission. The recipient
further agrees not to disclose these
contents hereof to any other parties
except for those specific purposes
for which this drawing was issued.


VT Halter Marine, Inc.
 **Vision Technologies
Systems**

DRAWN BY WH 7/10/03		ABS APPV	
CHECKED BY AE 8/6/03		USCG APPV	
APPROVED BY JO 9/4/03		OWNER APPV	
HULL NO APPLICABILITY		CAGE CODE 3B213	
ESTIMATE NO 00-104		SCALE NONE	

VESSEL	FRV40 CLASS 63m FISHERIES RESEARCH VESSEL
--------	---

DWG NO.	M282-085-FA01	SH 1
---------	---------------	------

PLOT: 1=1

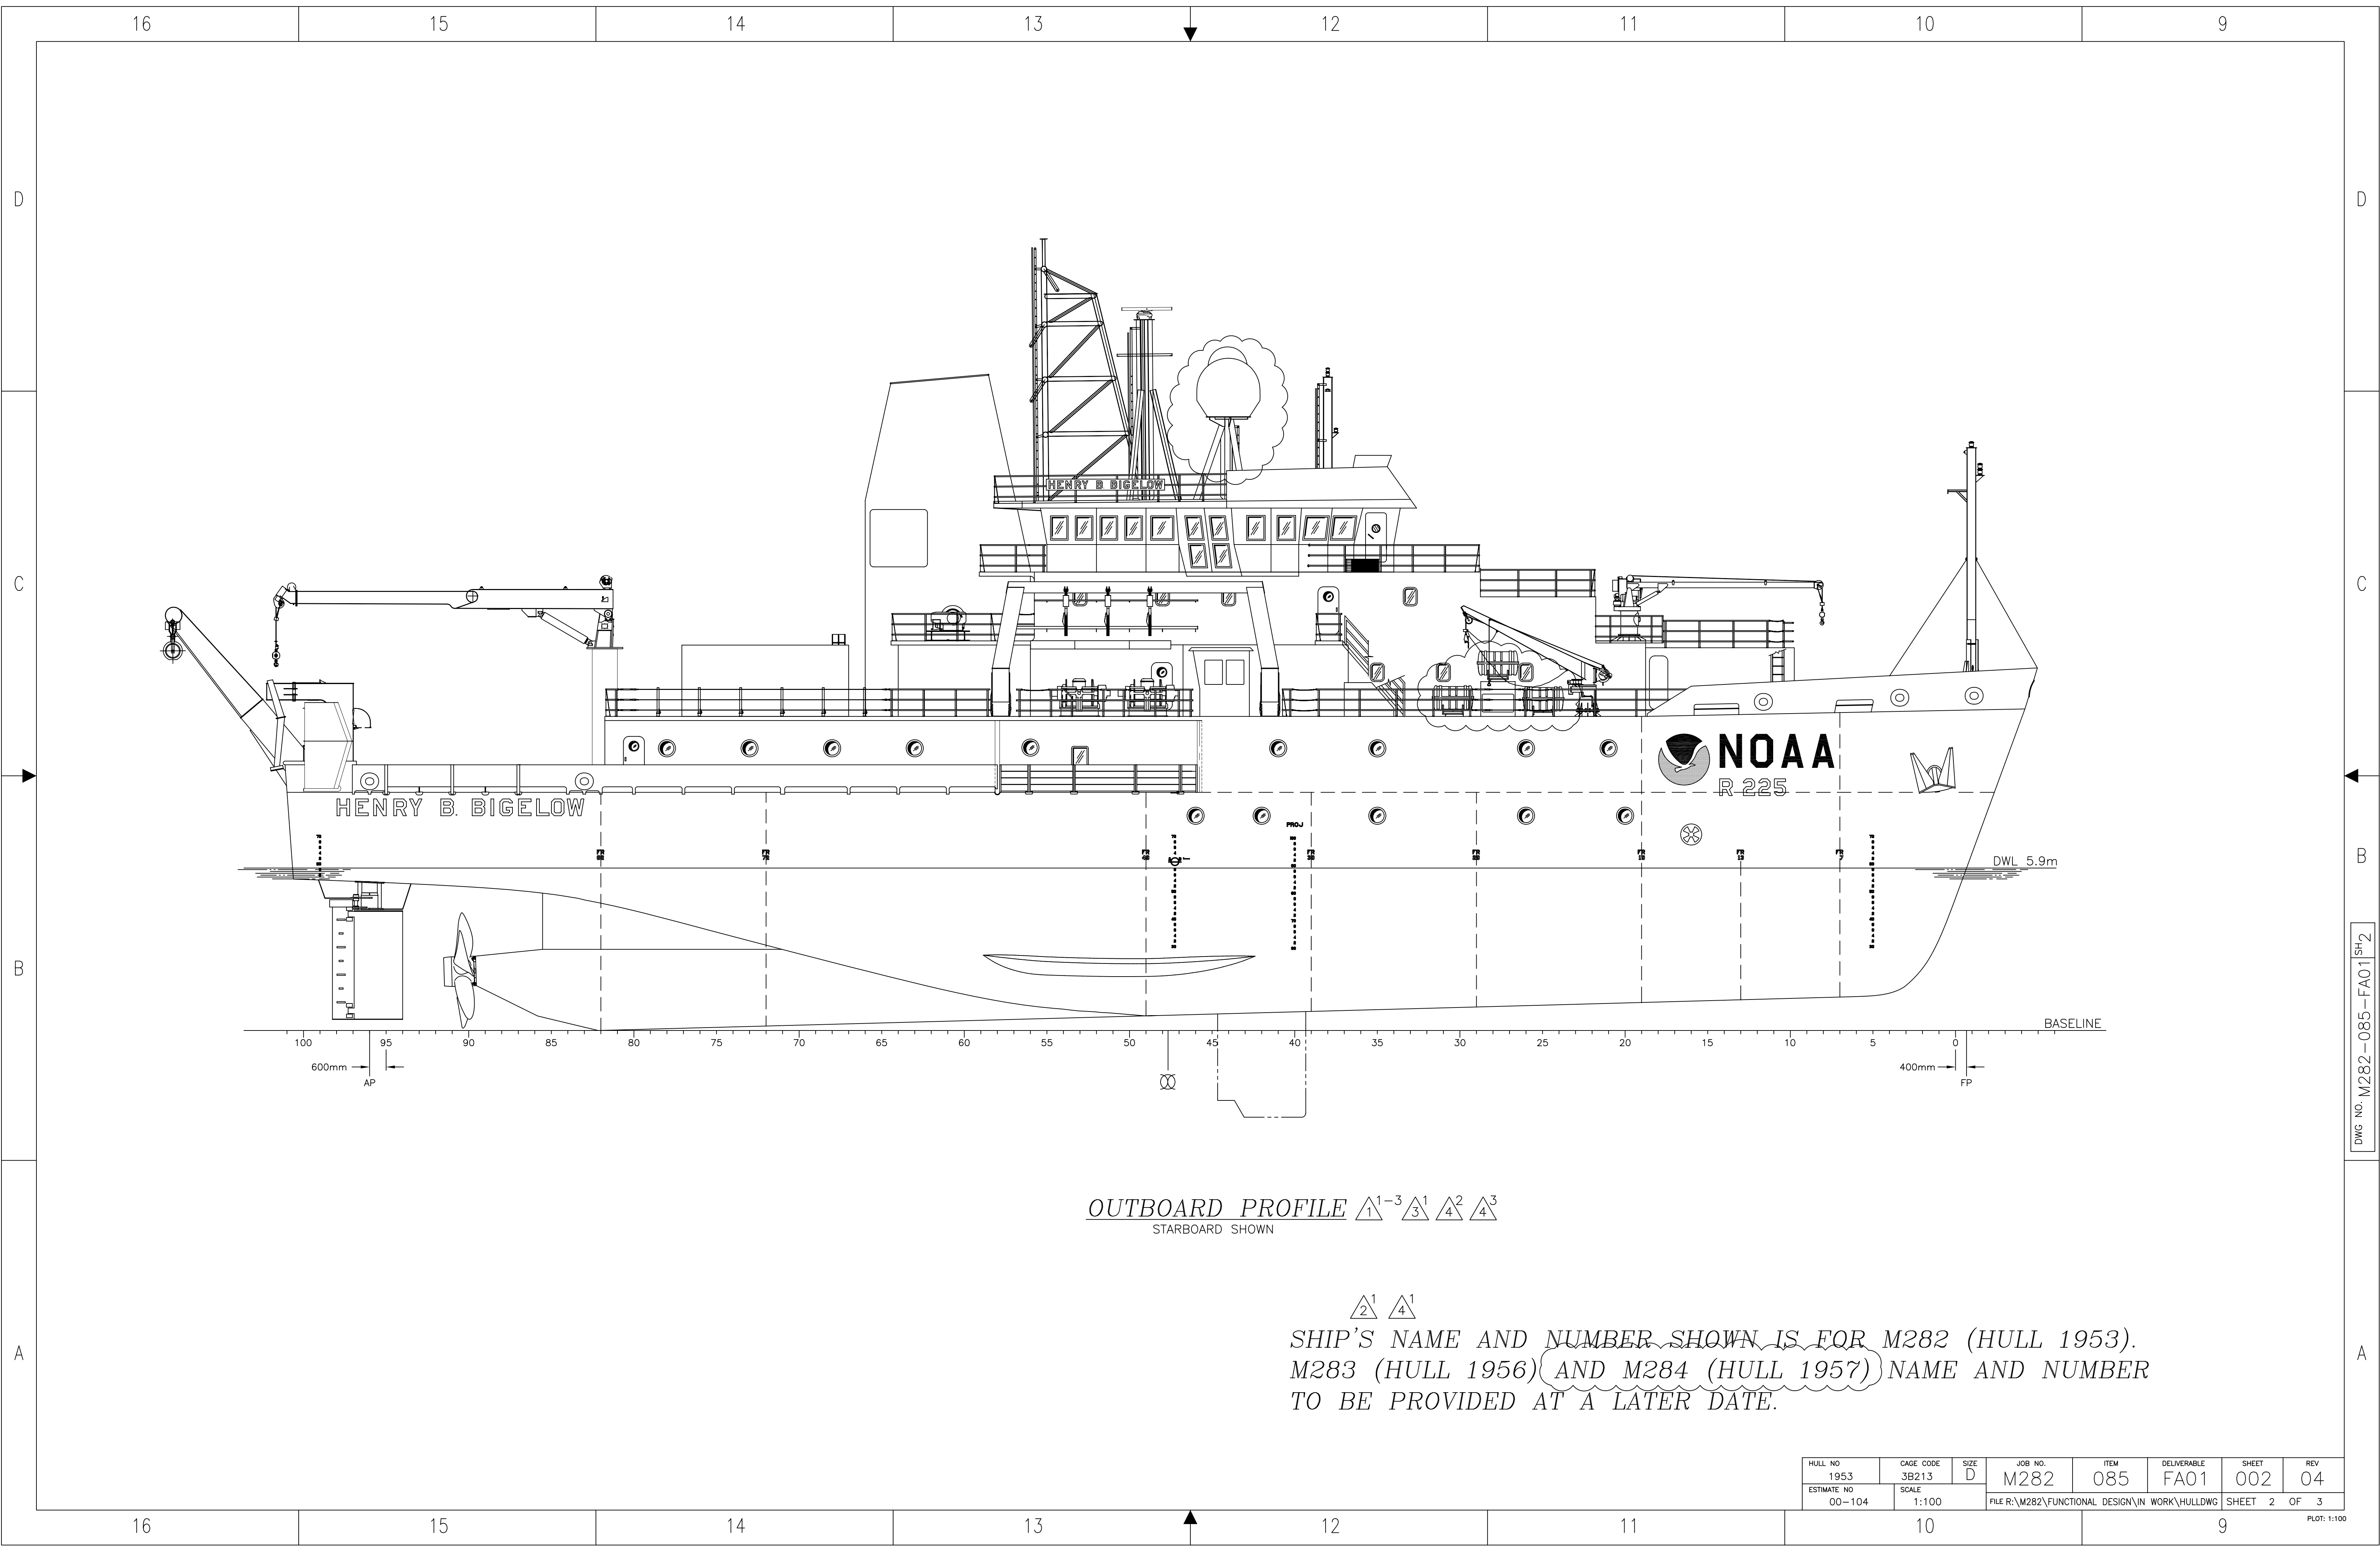


OUTBOARD PROFILE $\triangle_1^{1-3}$ $\triangle_3^1$ $\triangle_4^2$ $\triangle_4^3$
STARBOARD SHOWN

$\triangle_2^1$ $\triangle_4^1$
SHIP'S NAME AND NUMBER SHOWN IS FOR M282 (HULL 1953).
M283 (HULL 1956) AND M284 (HULL 1957) NAME AND NUMBER
TO BE PROVIDED AT A LATER DATE.

HULL NO 1953	CAGE CODE 3B213	SIZE D	JOB NO. M282	ITEM 085	DELIVERABLE FA01	SHEET 002	REV 04
ESTIMATE NO 00-104	SCALE 1:100	FILE R:\M282\FUNCTIONAL DESIGN\IN WORK\HULLDWG SHEET 2 OF 3					

PLOT: 1:100

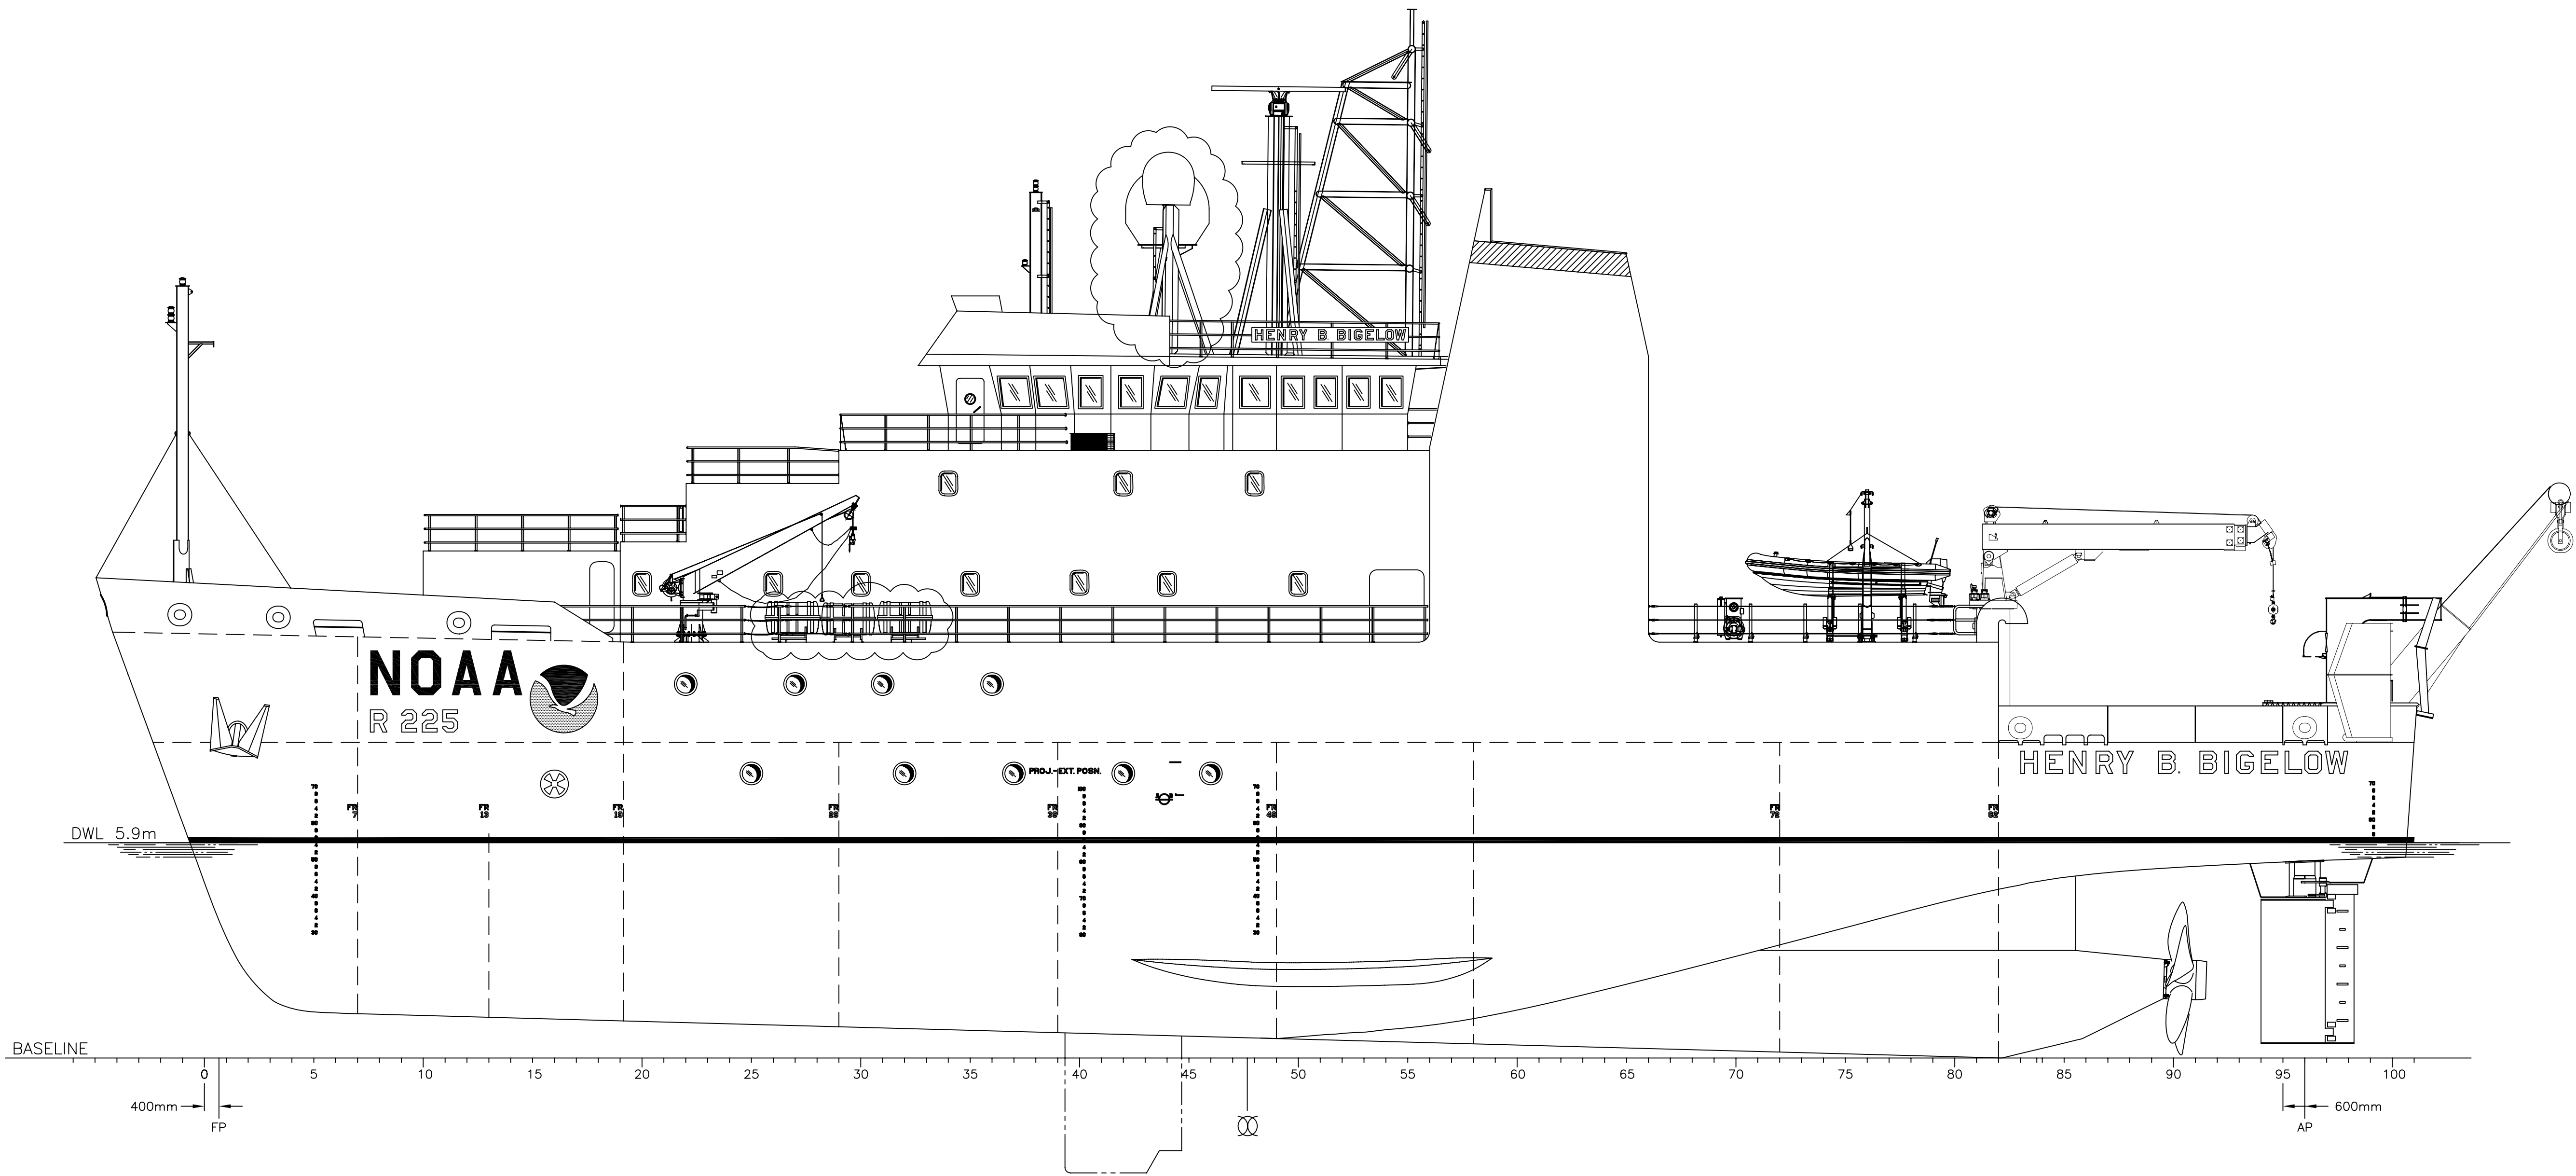

OUTBOARD PROFILE $\triangle_1^{1-4}$ $\triangle_4^2$ $\triangle_4^3$
PORT SHOWN

$\triangle_2^1$ $\triangle_4^1$
SHIP'S NAME AND NUMBER SHOWN IS FOR M282 (HULL 1953).
M283 (HULL 1956) AND M284 (HULL 1957) NAME AND NUMBER
TO BE PROVIDED AT A LATER DATE.

HULL NO 1953	CAGE CODE 3B213	SIZE D	JOB NO. M282	ITEM 085	DELIVERABLE FA01	SHEET 003	REV 04
ESTIMATE NO 00-104	SCALE 1:100	FILE R:\M282\FUNCTIONAL DESIGN\IN WORK\HULLDWG					
SHEET 3 OF 3						PLOT: 1-100	